


PINNACLE 101

SECOND FLOOR | AS-BUILT FLOOR PLAN

17851 N 85th Street • Scottsdale, AZ 85255

SUITE 250 | ±4,096 RSF

SEE THE VIDEO TOUR

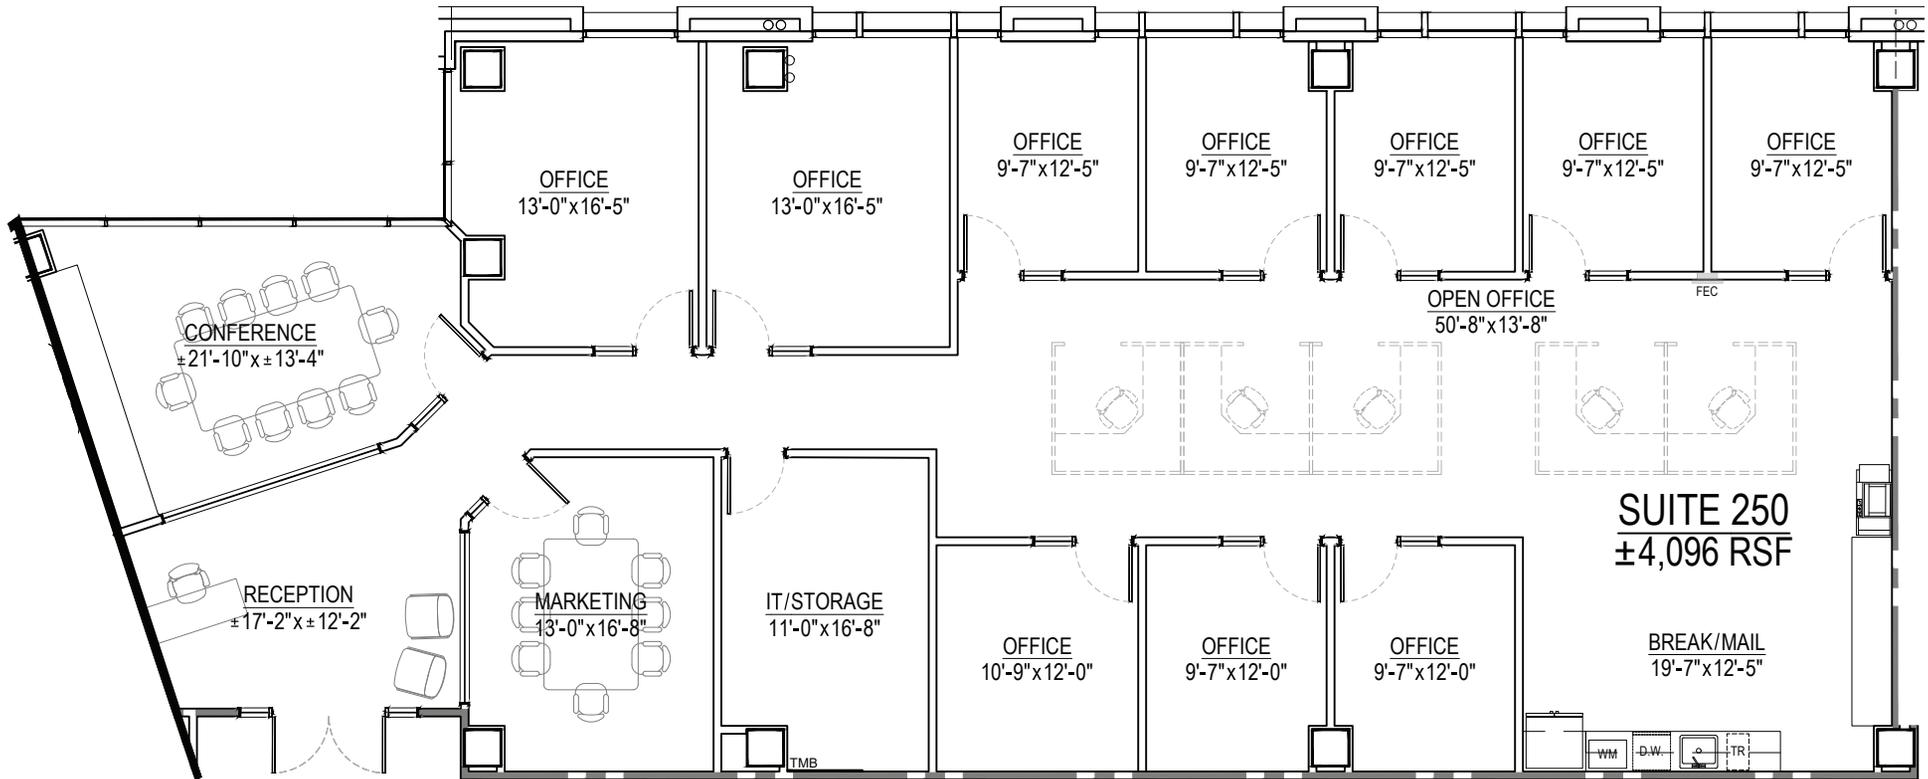

SUITE 250
±4,096 RSF

NOT TO SCALE



602-859-0506
JOHN QUATRINI
ASSOCIATE BROKER
john@shellcommercial.com

602-471-2981
SUZANNE ENRIGHT
SENIOR ASSOCIATE
suzanne@shellcommercial.com

PROPERTY OWNED
& MANAGED BY

