


PINNACLE 101

FIRST FLOOR | AS-BUILT FLOOR PLAN

17851 N 85th Street • Scottsdale, AZ 85255

SUITE 100 | ±7,001 RSF

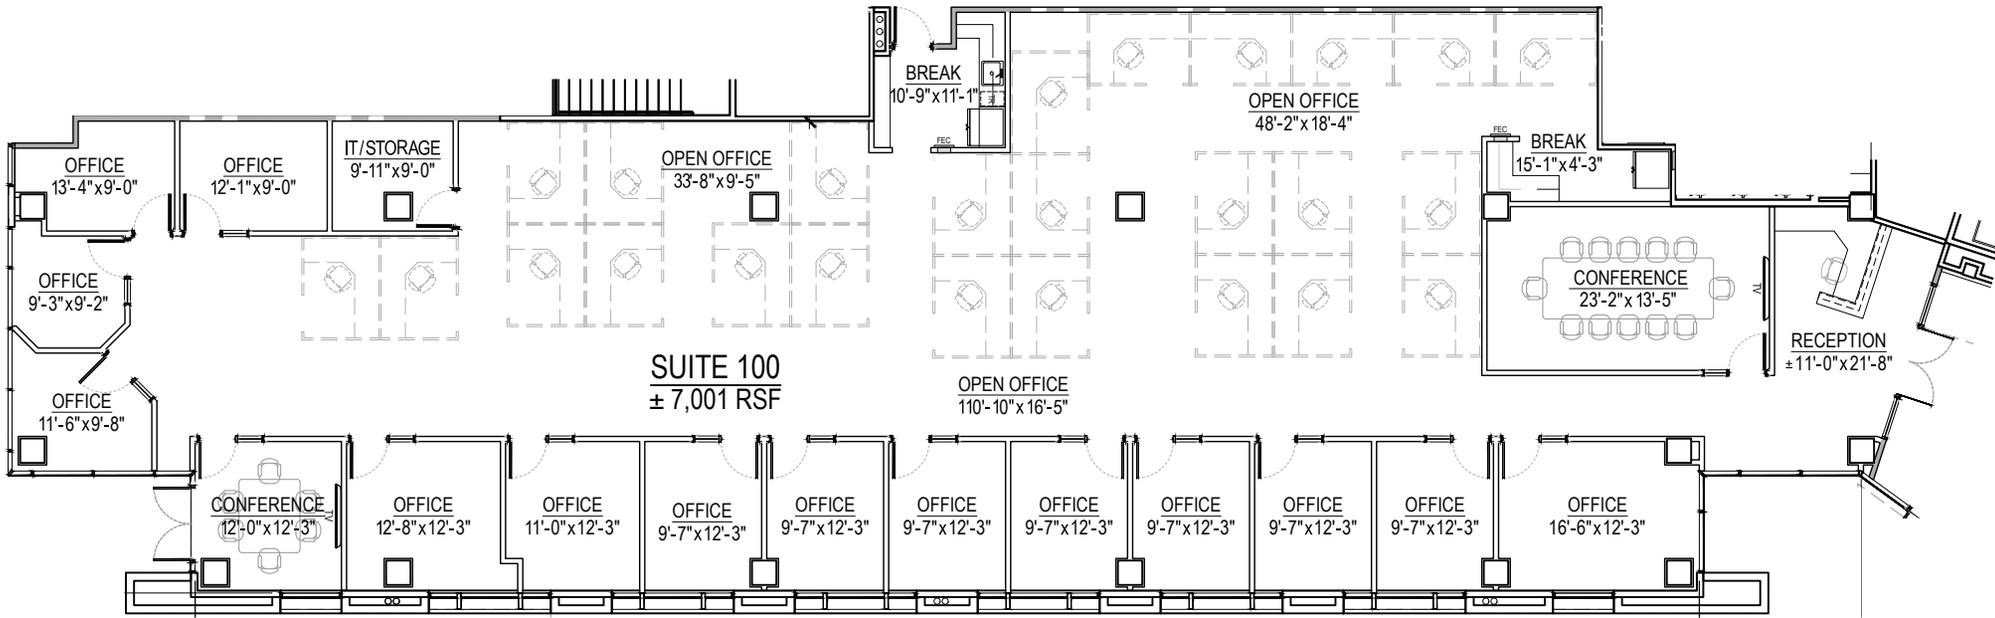

SUITE 100
± 7,001 RSF

NOT TO SCALE

 **SHELL**
Commercial Investment Real Estate
480-443-3992

602-859-0506
JOHN QUATRINI
ASSOCIATE BROKER
john@shellcommercial.com

602-471-2981
SUZANNE ENRIGHT
SENIOR ASSOCIATE
suzanne@shellcommercial.com

PROPERTY OWNED
& MANAGED BY

